

PREPARED BY

Wilson and Associates  
Engineers & Surveyors  
11005 Wilson Mills Road

Chardon, Ohio 44024

Date: March 7, 1974

Scale 1" = 30'

# SITE PLAN


FOXFIRE TRAILS SUBDIVISION

SUBLOT NO 9

VOLUME 5 PAGE 7

PAINESVILLE TOWNSHIP  
LAKE COUNTY OHIO

CASEMENT HOMES  
1251 MANSION AVE  
PAINESVILLE, OHIO

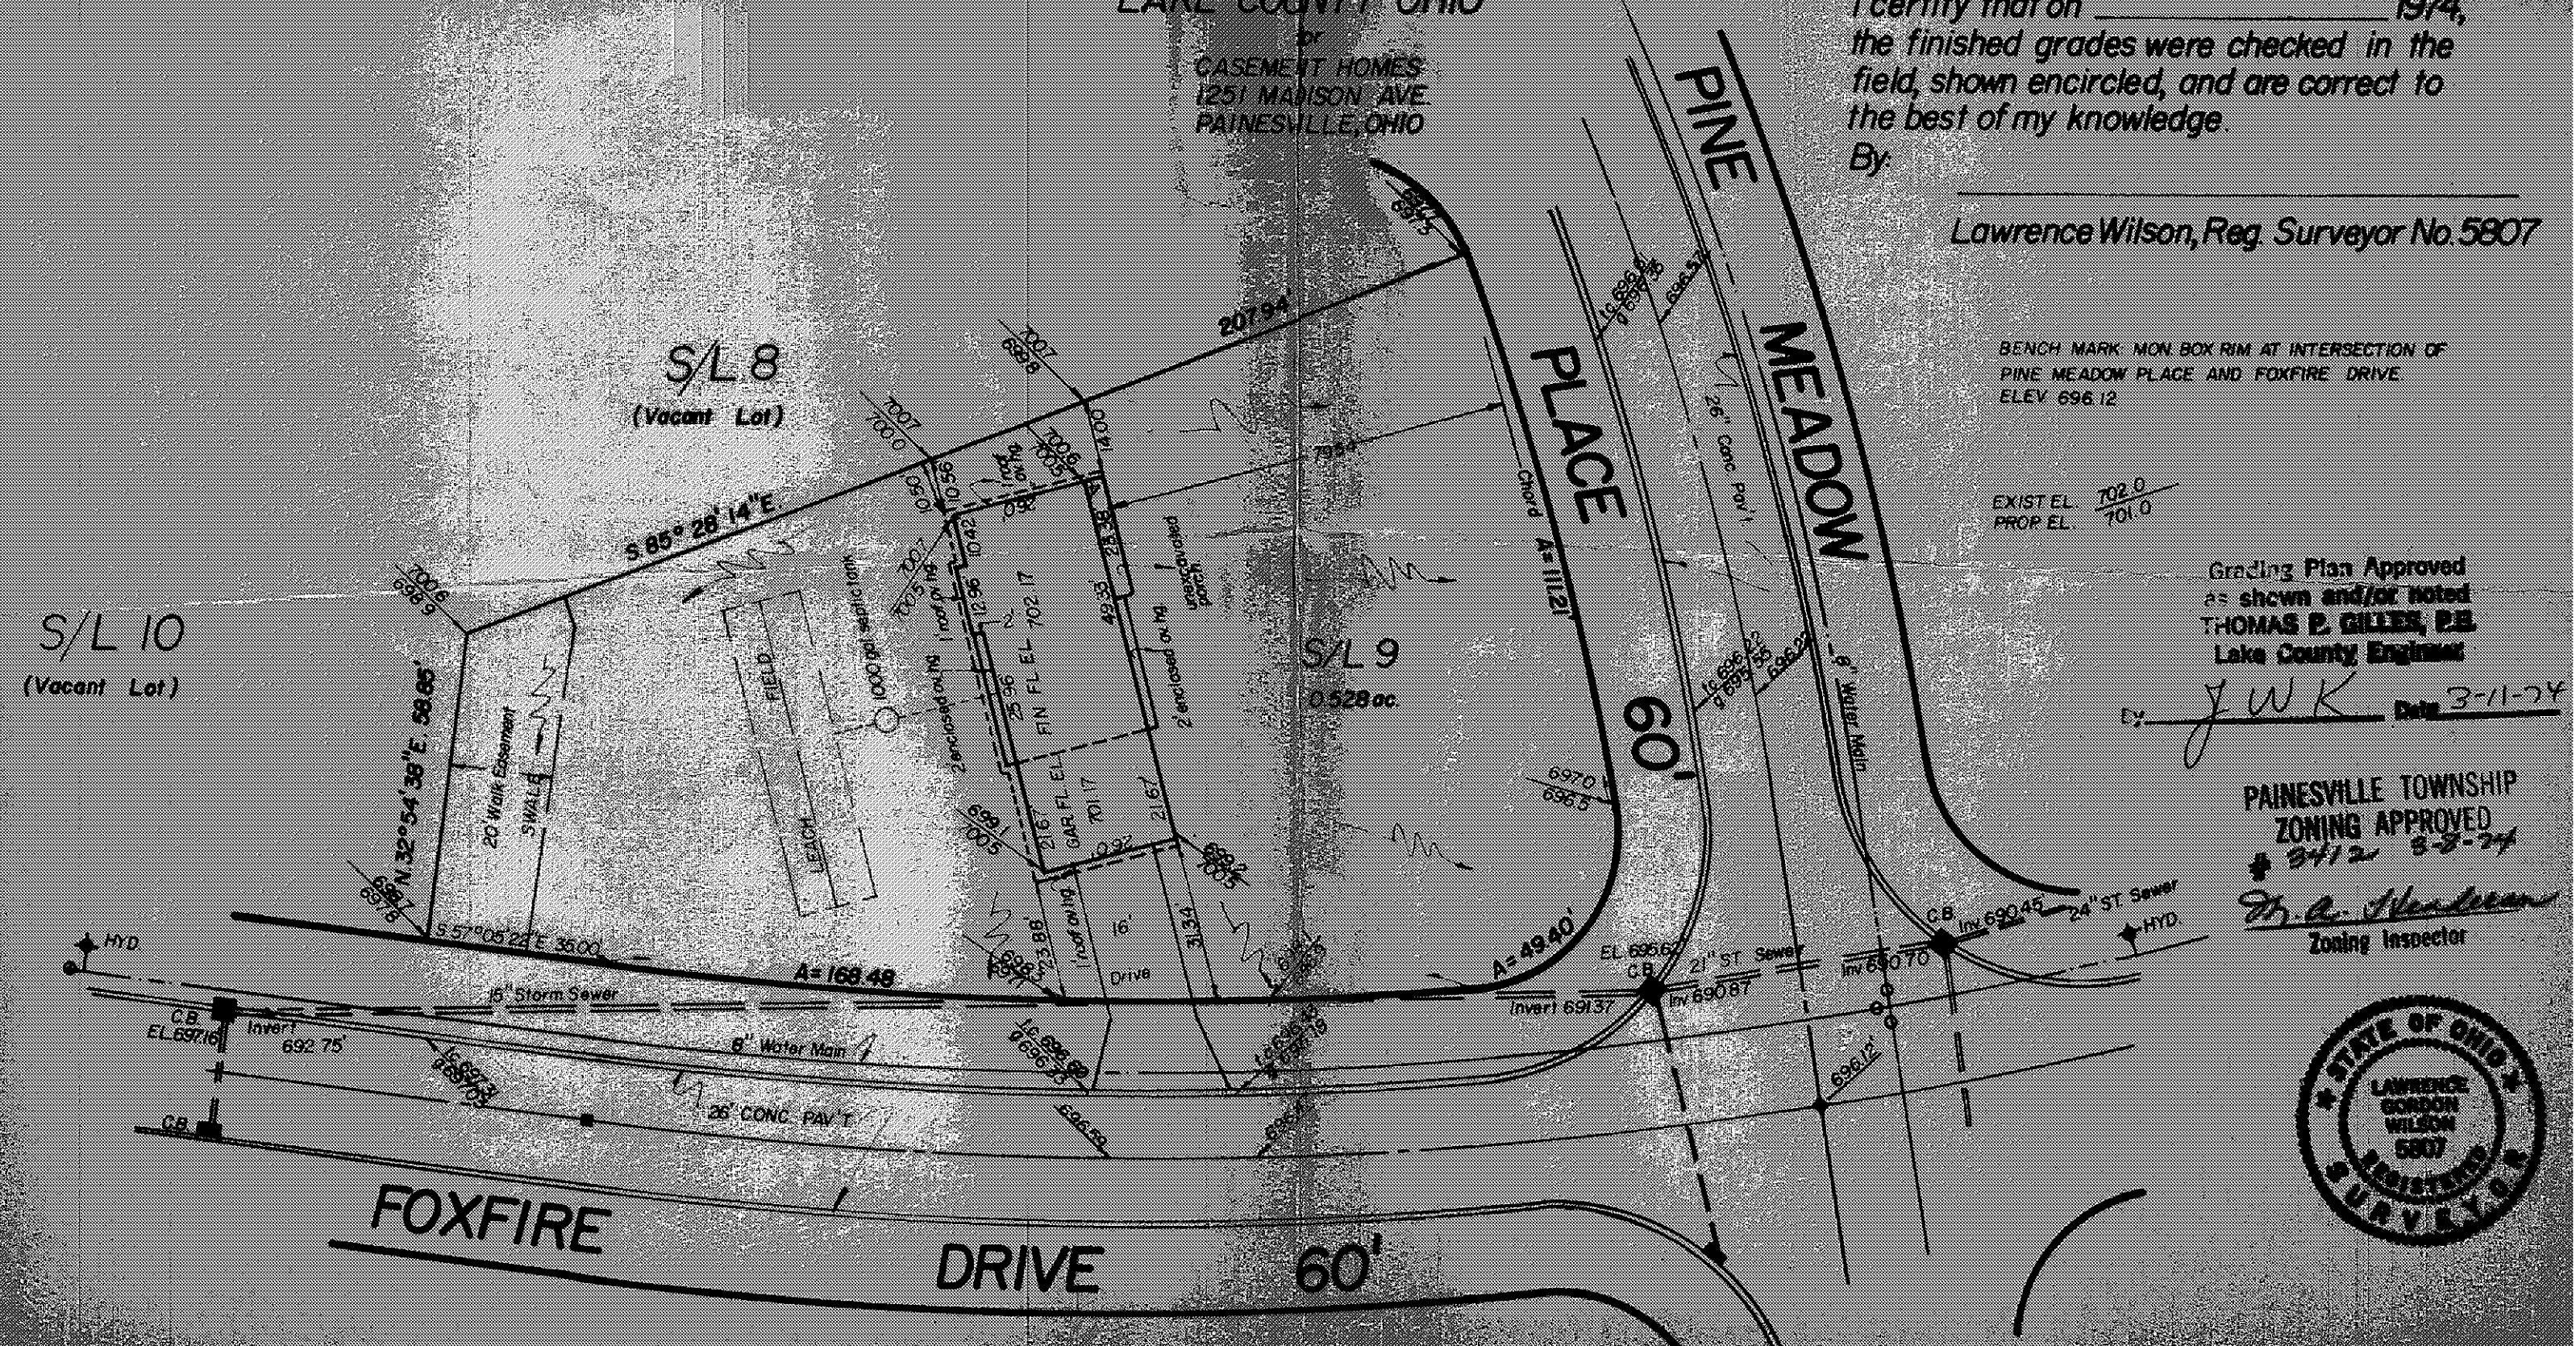

## CERTIFICATION

I certify that this plat was prepared by me,  
and is correct to the best of my knowledge  
By:

Lawrence Wilson

Lawrence Wilson, Reg. Surveyor No 5807

## 'AS BUILT' CERTIFICATION

I certify that on \_\_\_\_\_ 1974,  
the finished grades were checked in the  
field, shown encircled, and are correct to  
the best of my knowledge.

By:

Lawrence Wilson, Reg. Surveyor No 5807

BENCH MARK MON BOX RIM AT INTERSECTION OF  
PINE MEADOW PLACE AND FOXFIRE DRIVE  
ELEV 696.12

EXIST EL PROP EL 702.0  
701.0

Grading Plan Approved  
as shown and/or noted  
THOMAS P. MILLER, P.E.  
Lake County Engineer

J.W.K. Date 3-11-74

PAINESVILLE TOWNSHIP  
ZONING APPROVED  
# 3412 3-2-74

St. C. Johnson  
Zoning Inspector

